





AS BUILT GROUND FLOOR PLAN

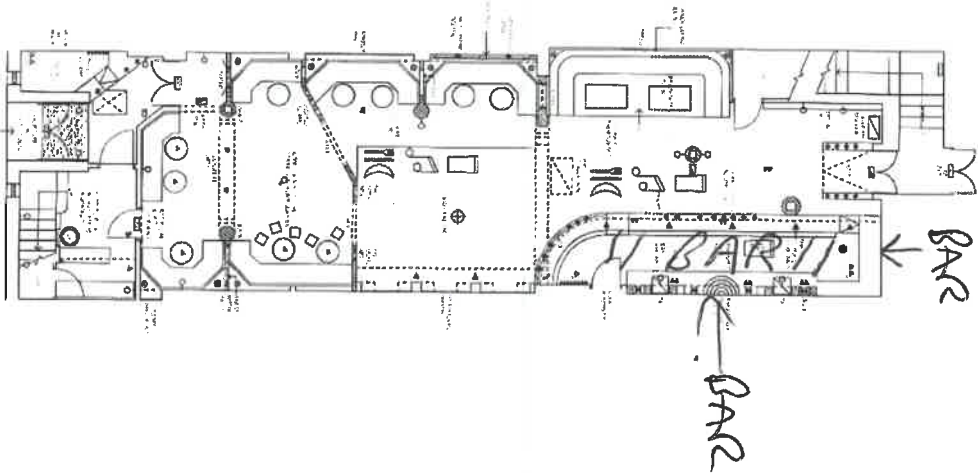

AS BUILT FIRST FLOOR PLAN

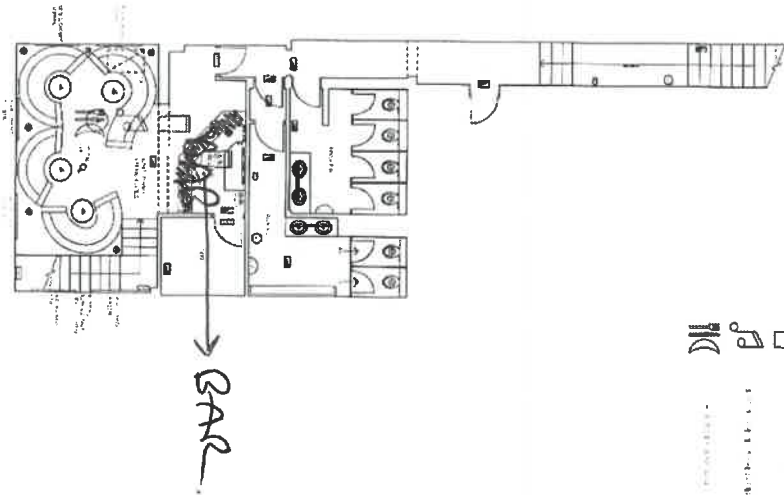

<p>PO NA NA PO NA NA PO NA NA</p>		<p>AS BUILT GROUND FLOOR PLAN AS BUILT FIRST FLOOR PLAN</p>
<p>DATE: 10/07/2014 DRAWN: [Name] CHECKED: [Name]</p>		<p>1:100 1:100 1:100</p>

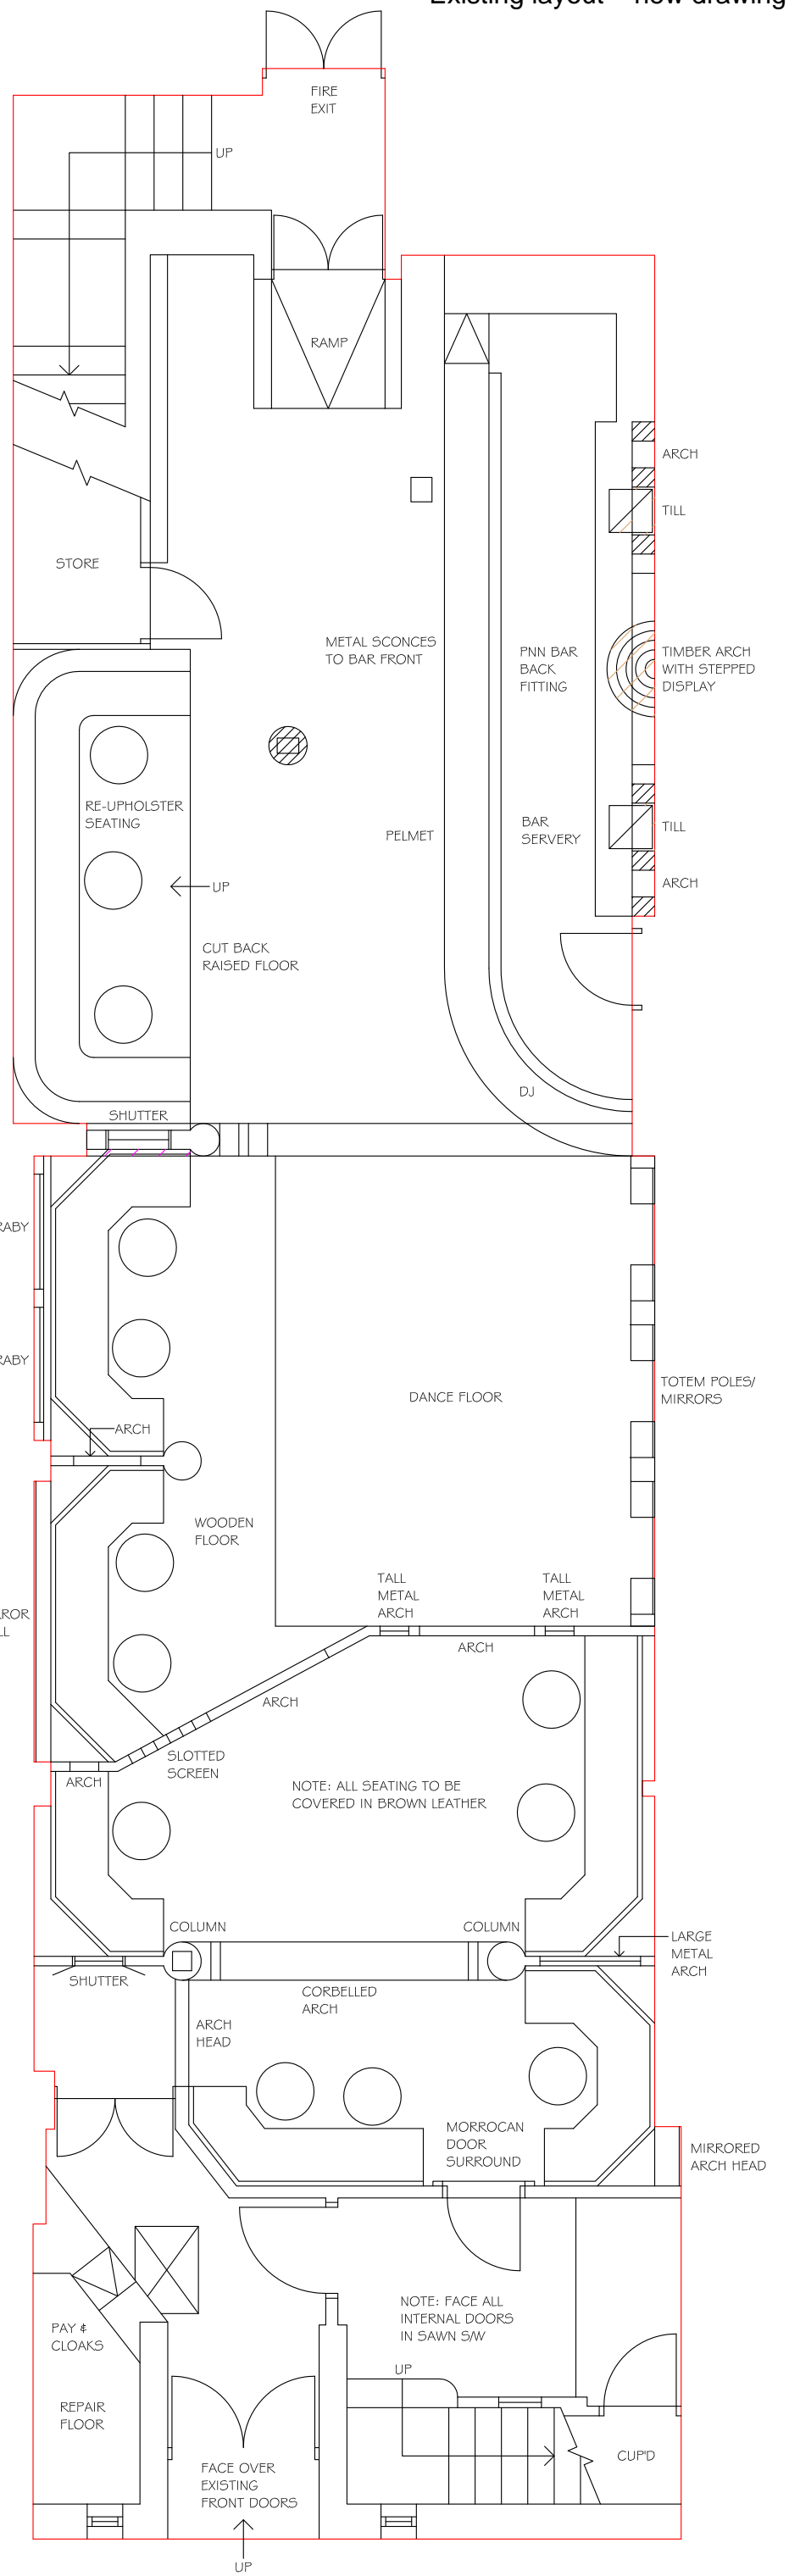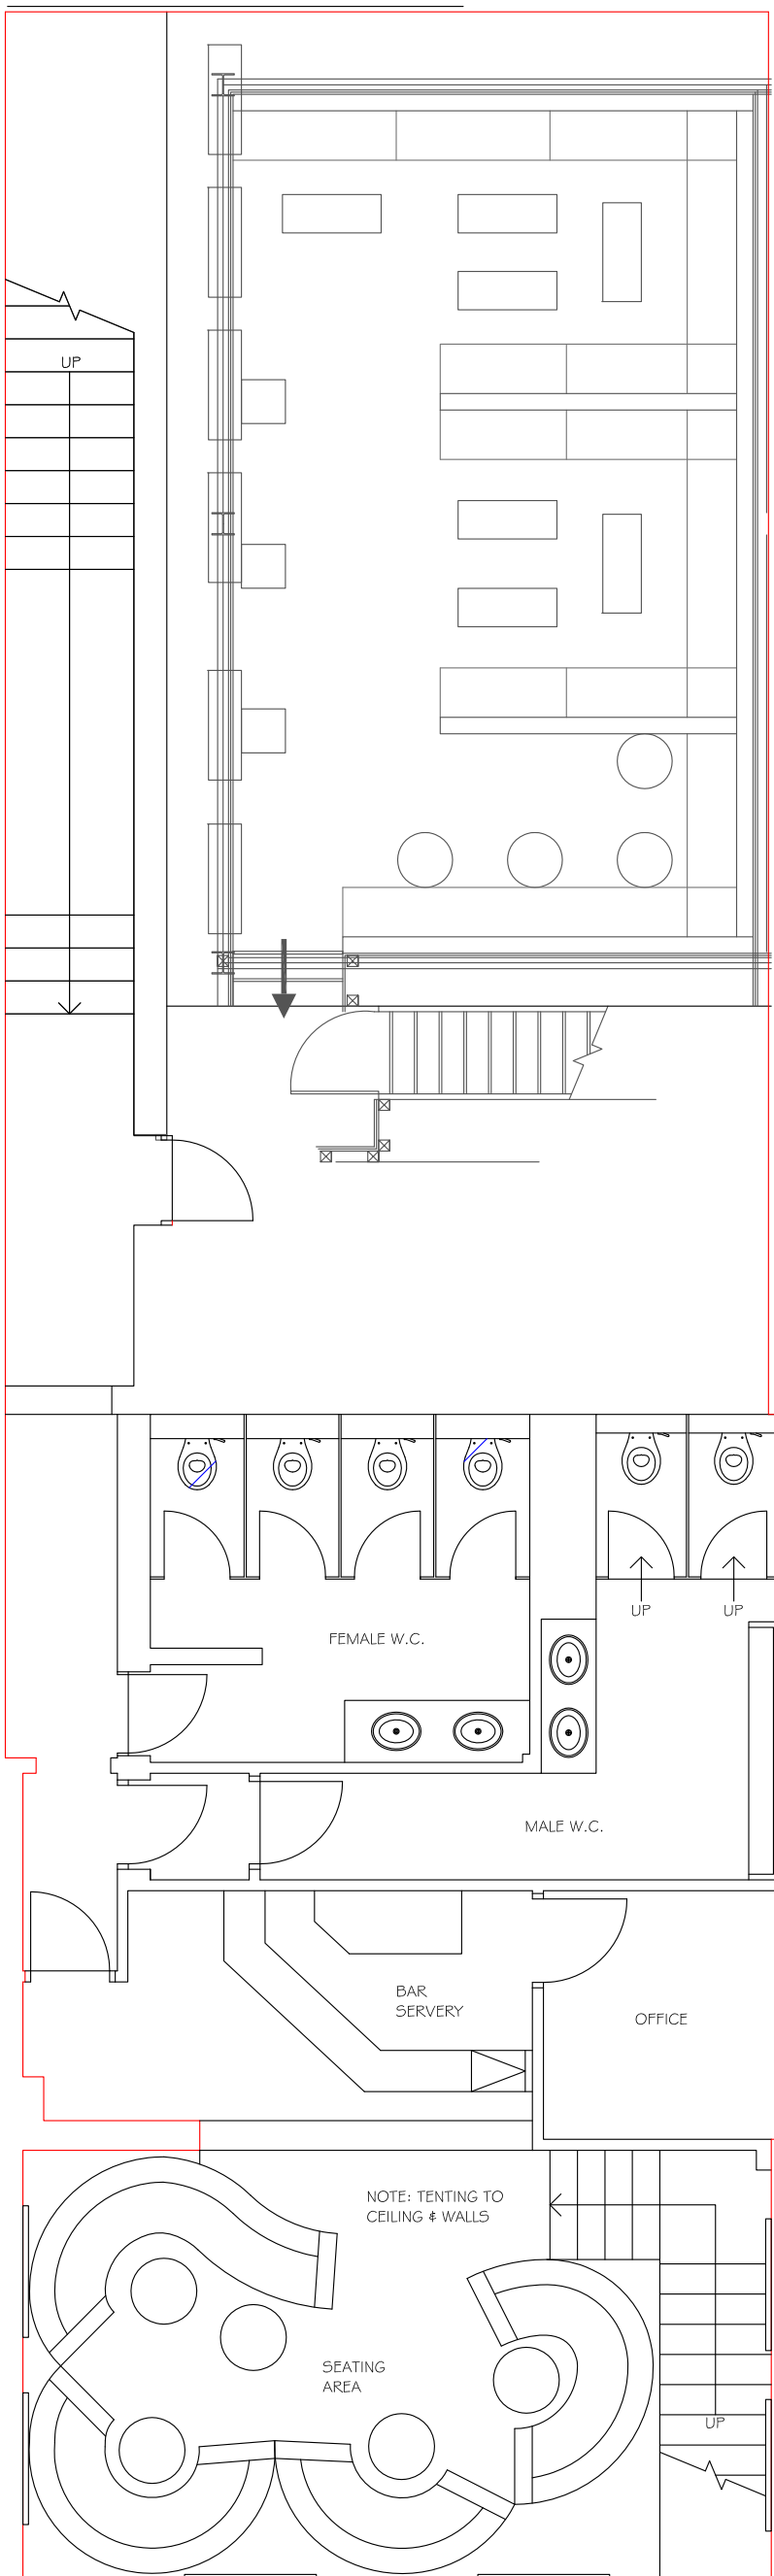

This page is intentionally left blank